



File Name: M:\Projects\State of NJ\11202-RECORD SET-Switchgear and Transformer Upgrade - NJ DOT\elec\11202E60.dwg
Xref: 11202E60.dwg
Layout Tab: E60 Image
Ploited on: Jul 15, 2014 - 1:43pm Plotted by:temper
R.C.G. & P. INC.
COPYRIGHT 2012
ALL RIGHTS RESERVED

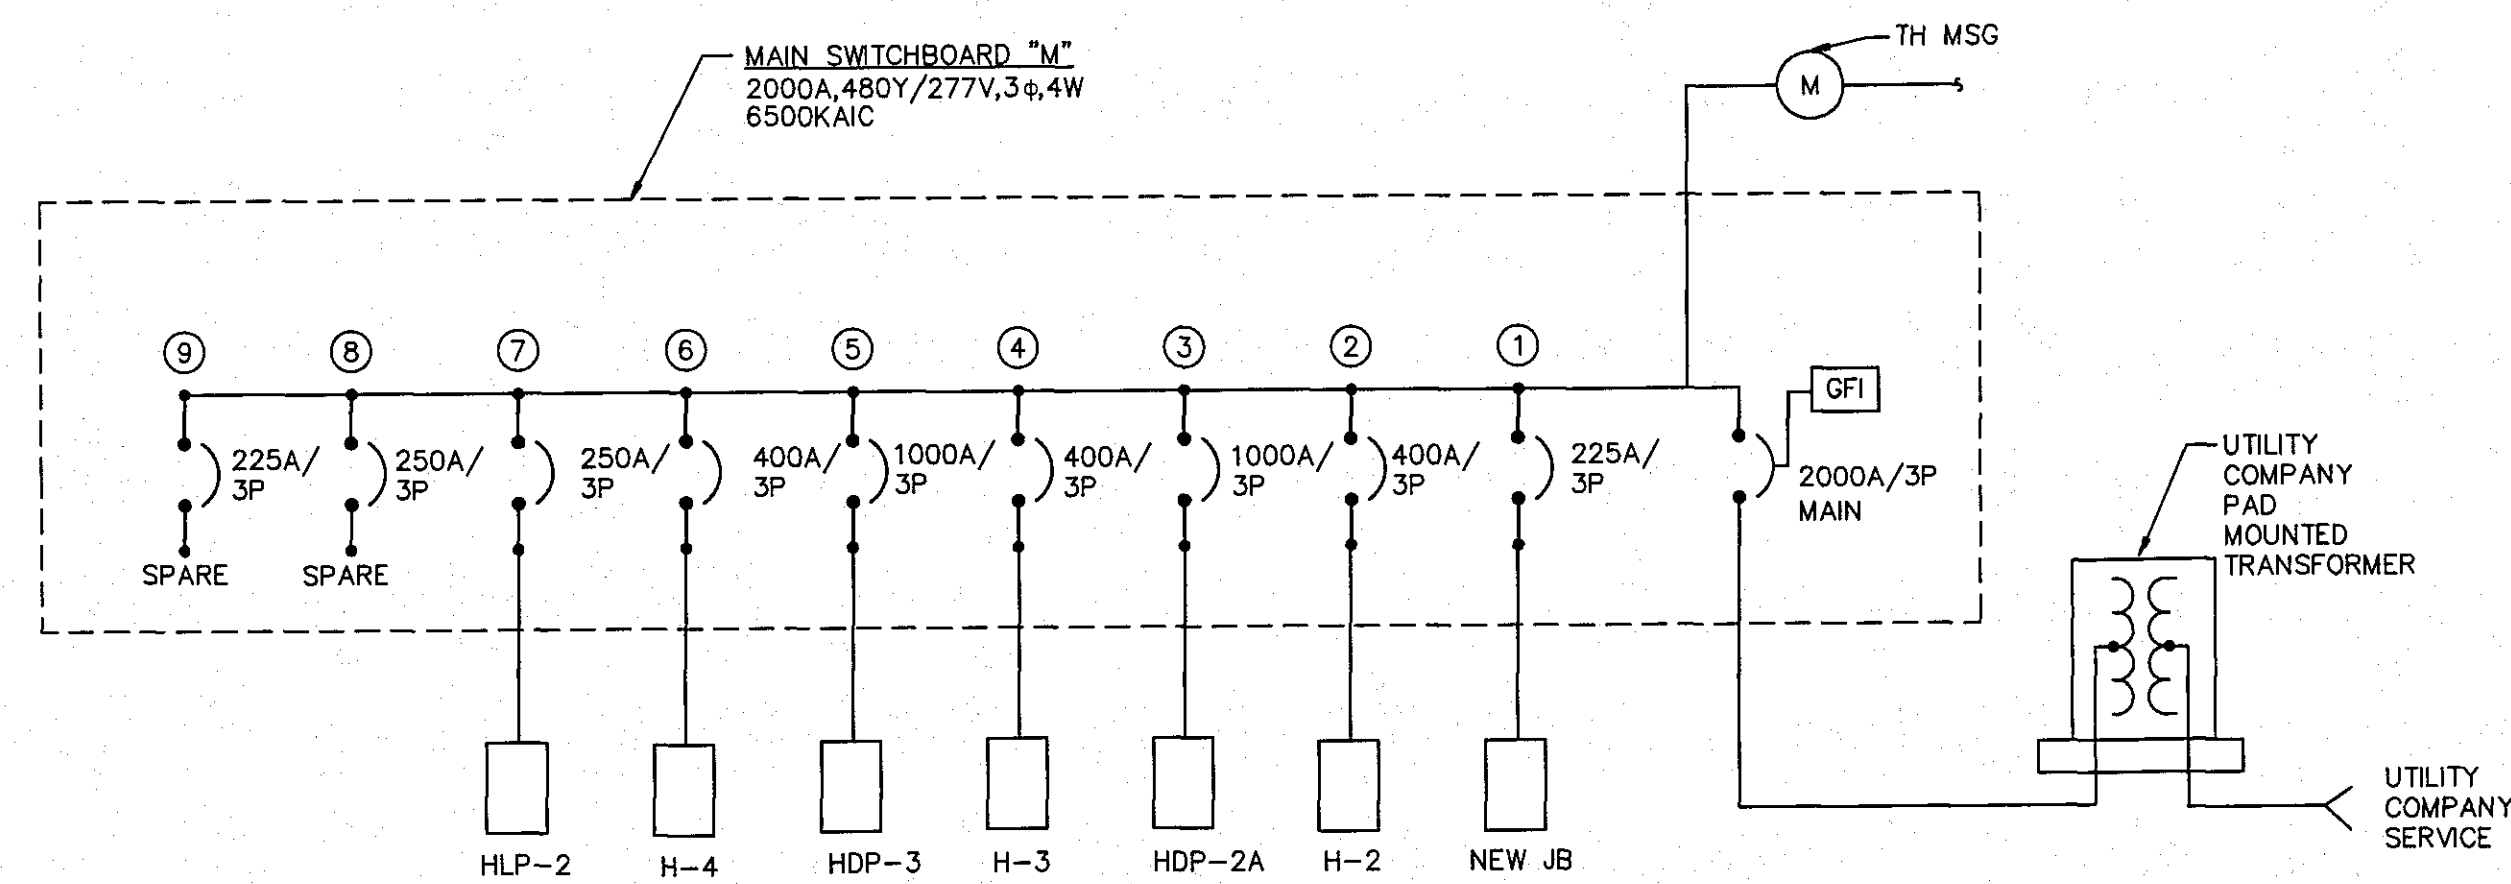

THIOL BUILDING ONE-LINE DIAGRAM
SCALE: NO SCALE

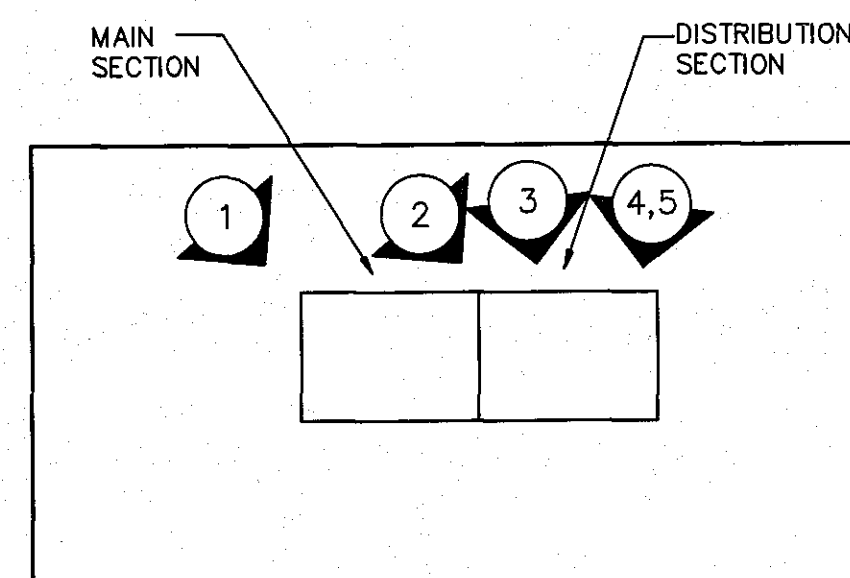

THIOL BUILDING ELECTRIC ROOM FLOOR PLAN
SCALE: NO SCALE

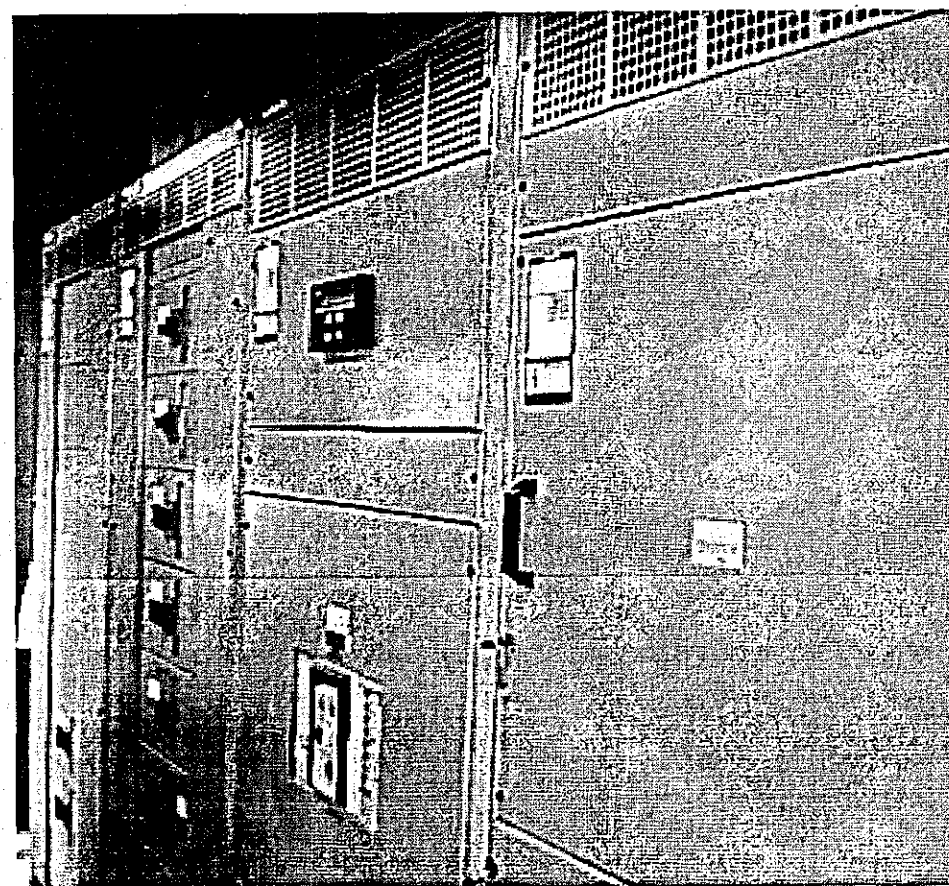


PHOTO 1

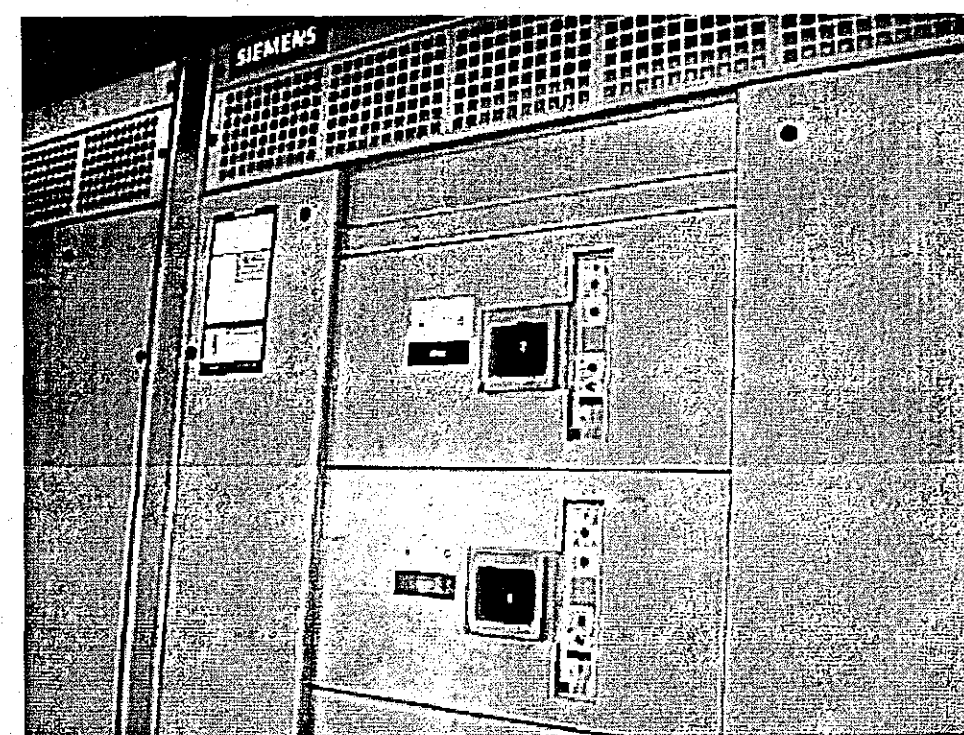


PHOTO 2



PHOTO 3

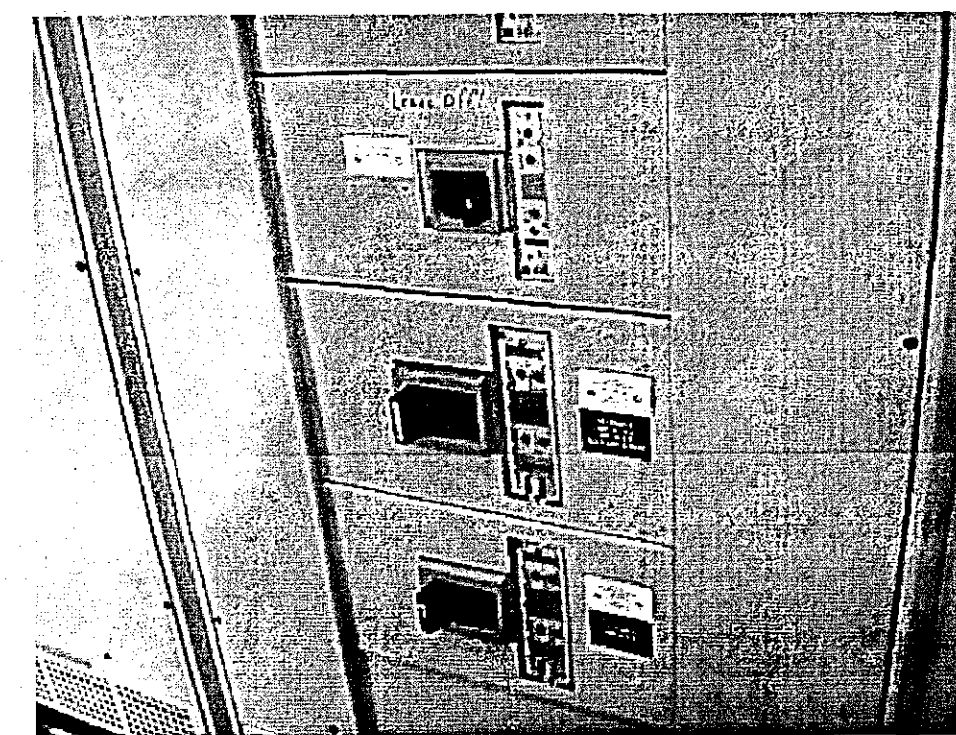


PHOTO 4

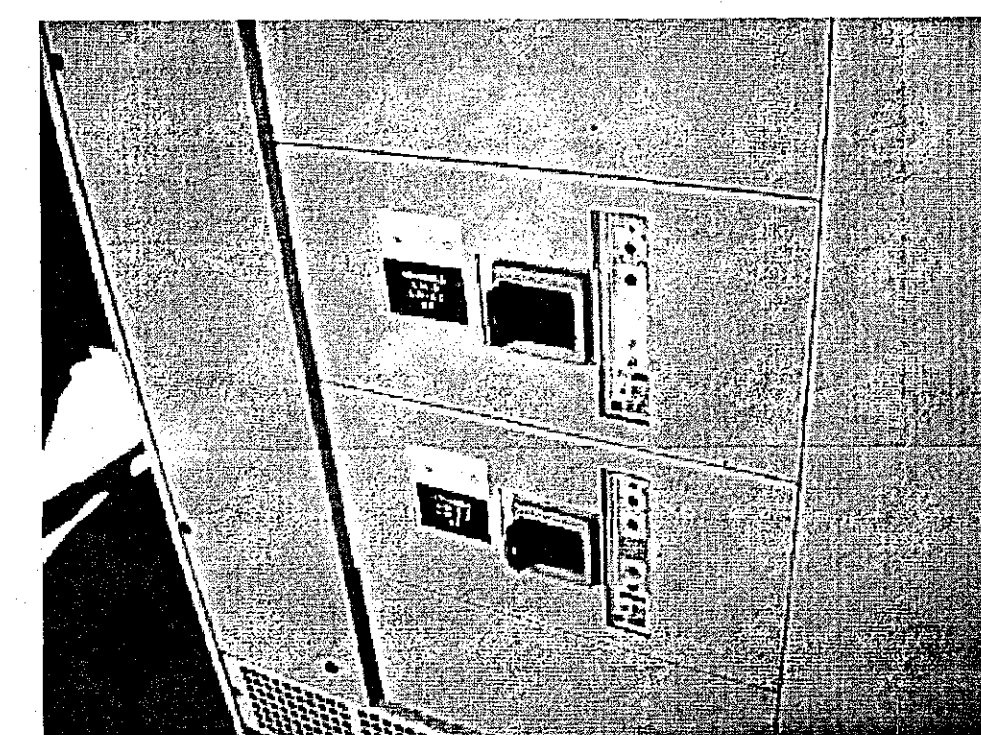


PHOTO 5

RECORD SET DWG.
DATE JUNE 2014

THE AS-BUILT INFORMATION ADDED TO THIS DRAWING(S) HAS BEEN SUPPLIED BY THE CONTRACTOR(S). BIAGI, CHANCE, CUMMINS, LONDON, TITZER, INC. (BCCLT INC.) DOES NOT ASSUME THE RESPONSIBILITY FOR ITS ACCURACY OTHER THAN CONFORMITY WITH THE DESIGN CONCEPT AND GENERAL ADEQUACY OF THE AS-BUILT INFORMATION TO THE BEST OF BCCLT, INC. KNOWLEDGE.

F/A BUILDING SWITCHGEAR AND TRANSFORMER UPGRADE
NEW JERSEY DEPARTMENT OF TRANSPORTATION
TRENTON, NEW JERSEY

SCALE
**THIOL BUILDING ONE-LINE DAIGRAM
AND FLOOR PLAN**

RECORD SET

Biagi,Chance,Cummins,London,Titzer,Inc.
Consulting Engineers

E6.0

COMM. NO. 11202 DRAWN BY BAK CHECKED BY JMF DATE 4/09/12